

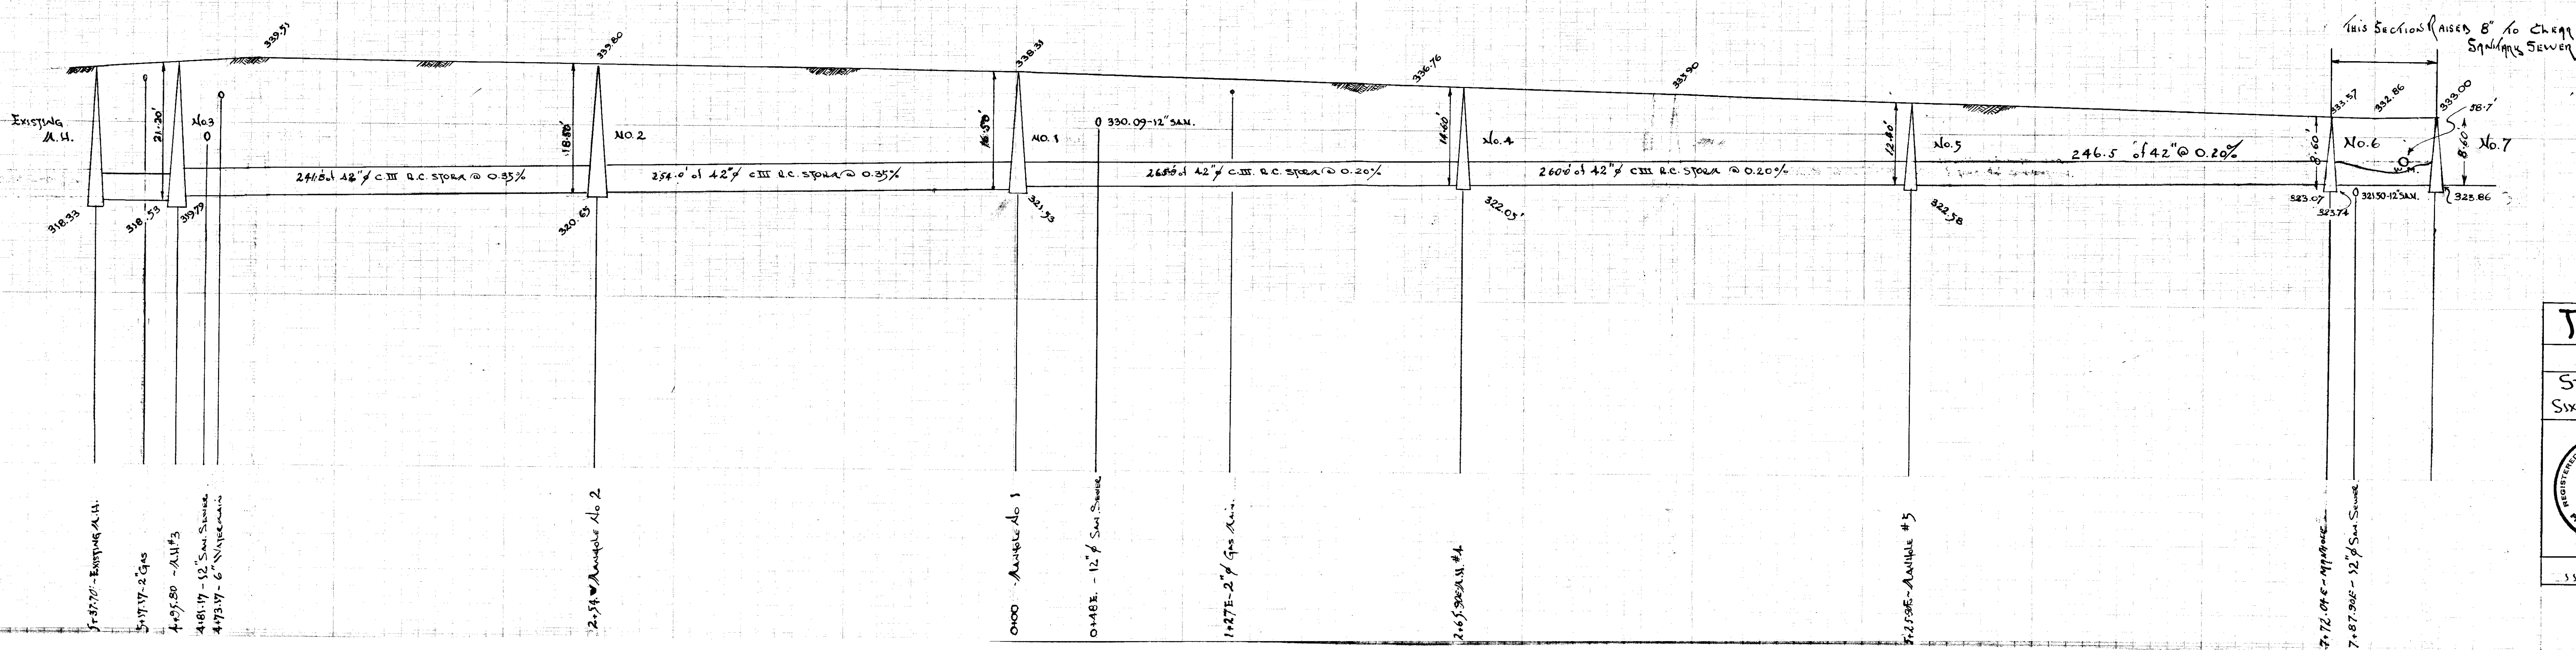


Appendix A. As-built Drawings

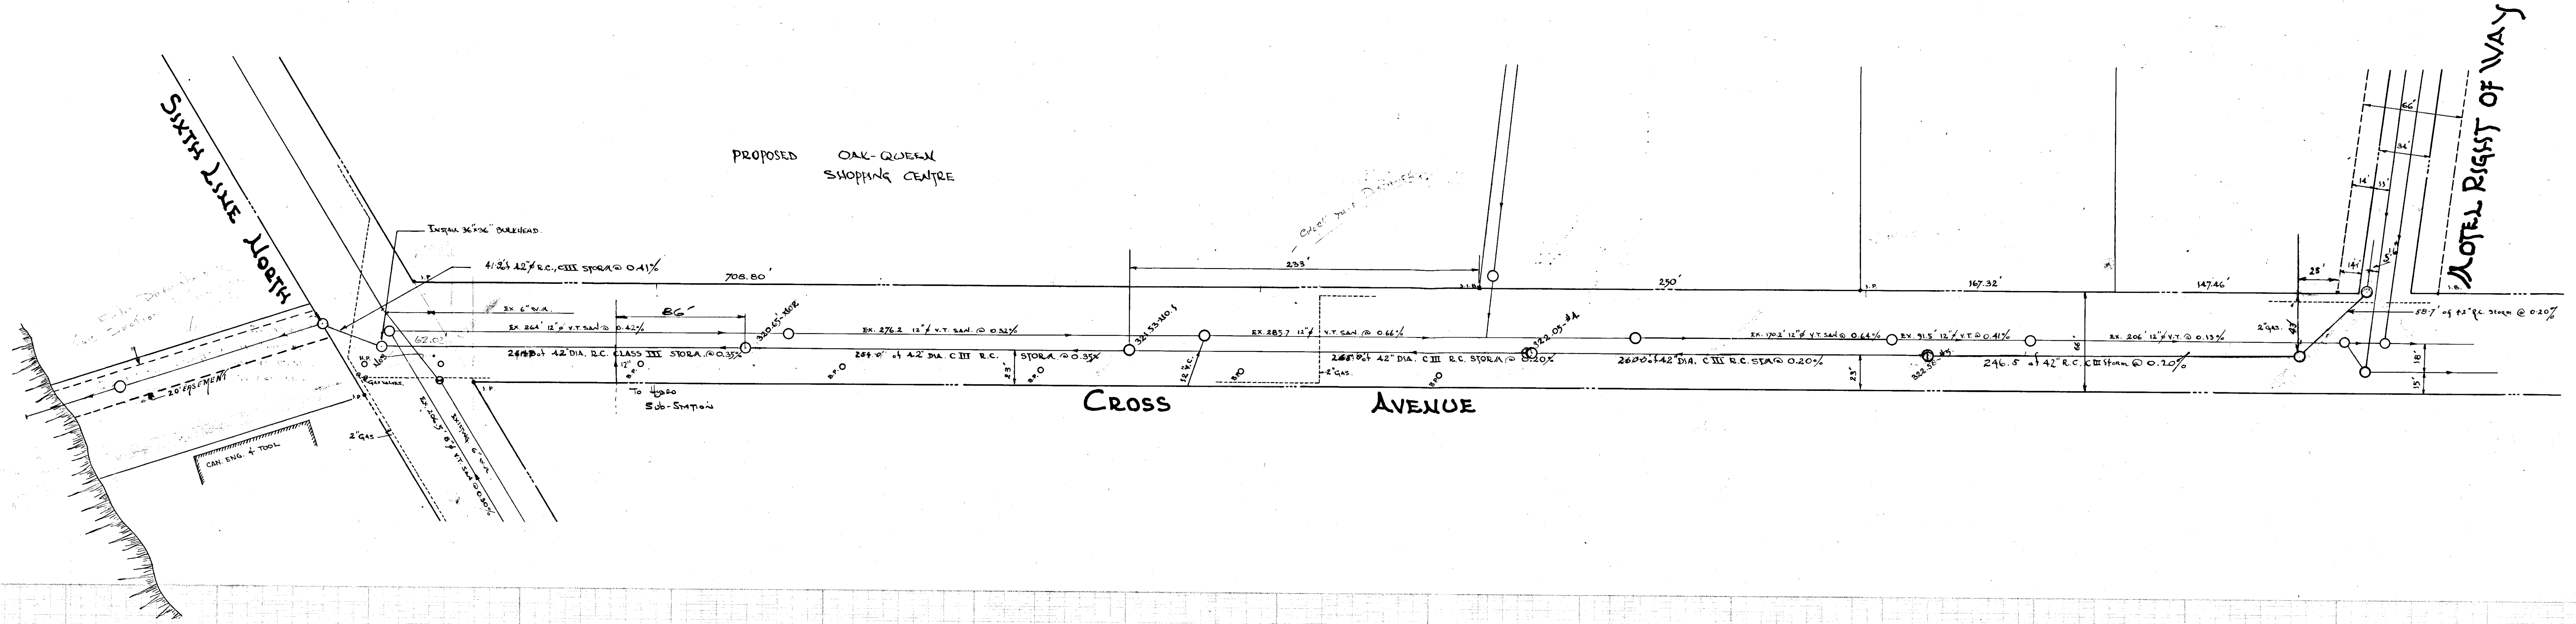

TOWN of OAKVILLE	
SEWER SYSTEM	
STORM SEWER ON CROSS AVE FROM SIXTEEN MILE CREEK TO MOTOR R.O.W.	
OCTOBER 13 TH 1960	
	C-41
	R.W.J. Moore B.A.Sc., P. Eng. Town Engineer
	Drawn by S.W. Hume
SCALES: 1" = 10 FEET VERT. & 1" = 40 FEET HORIZ.	

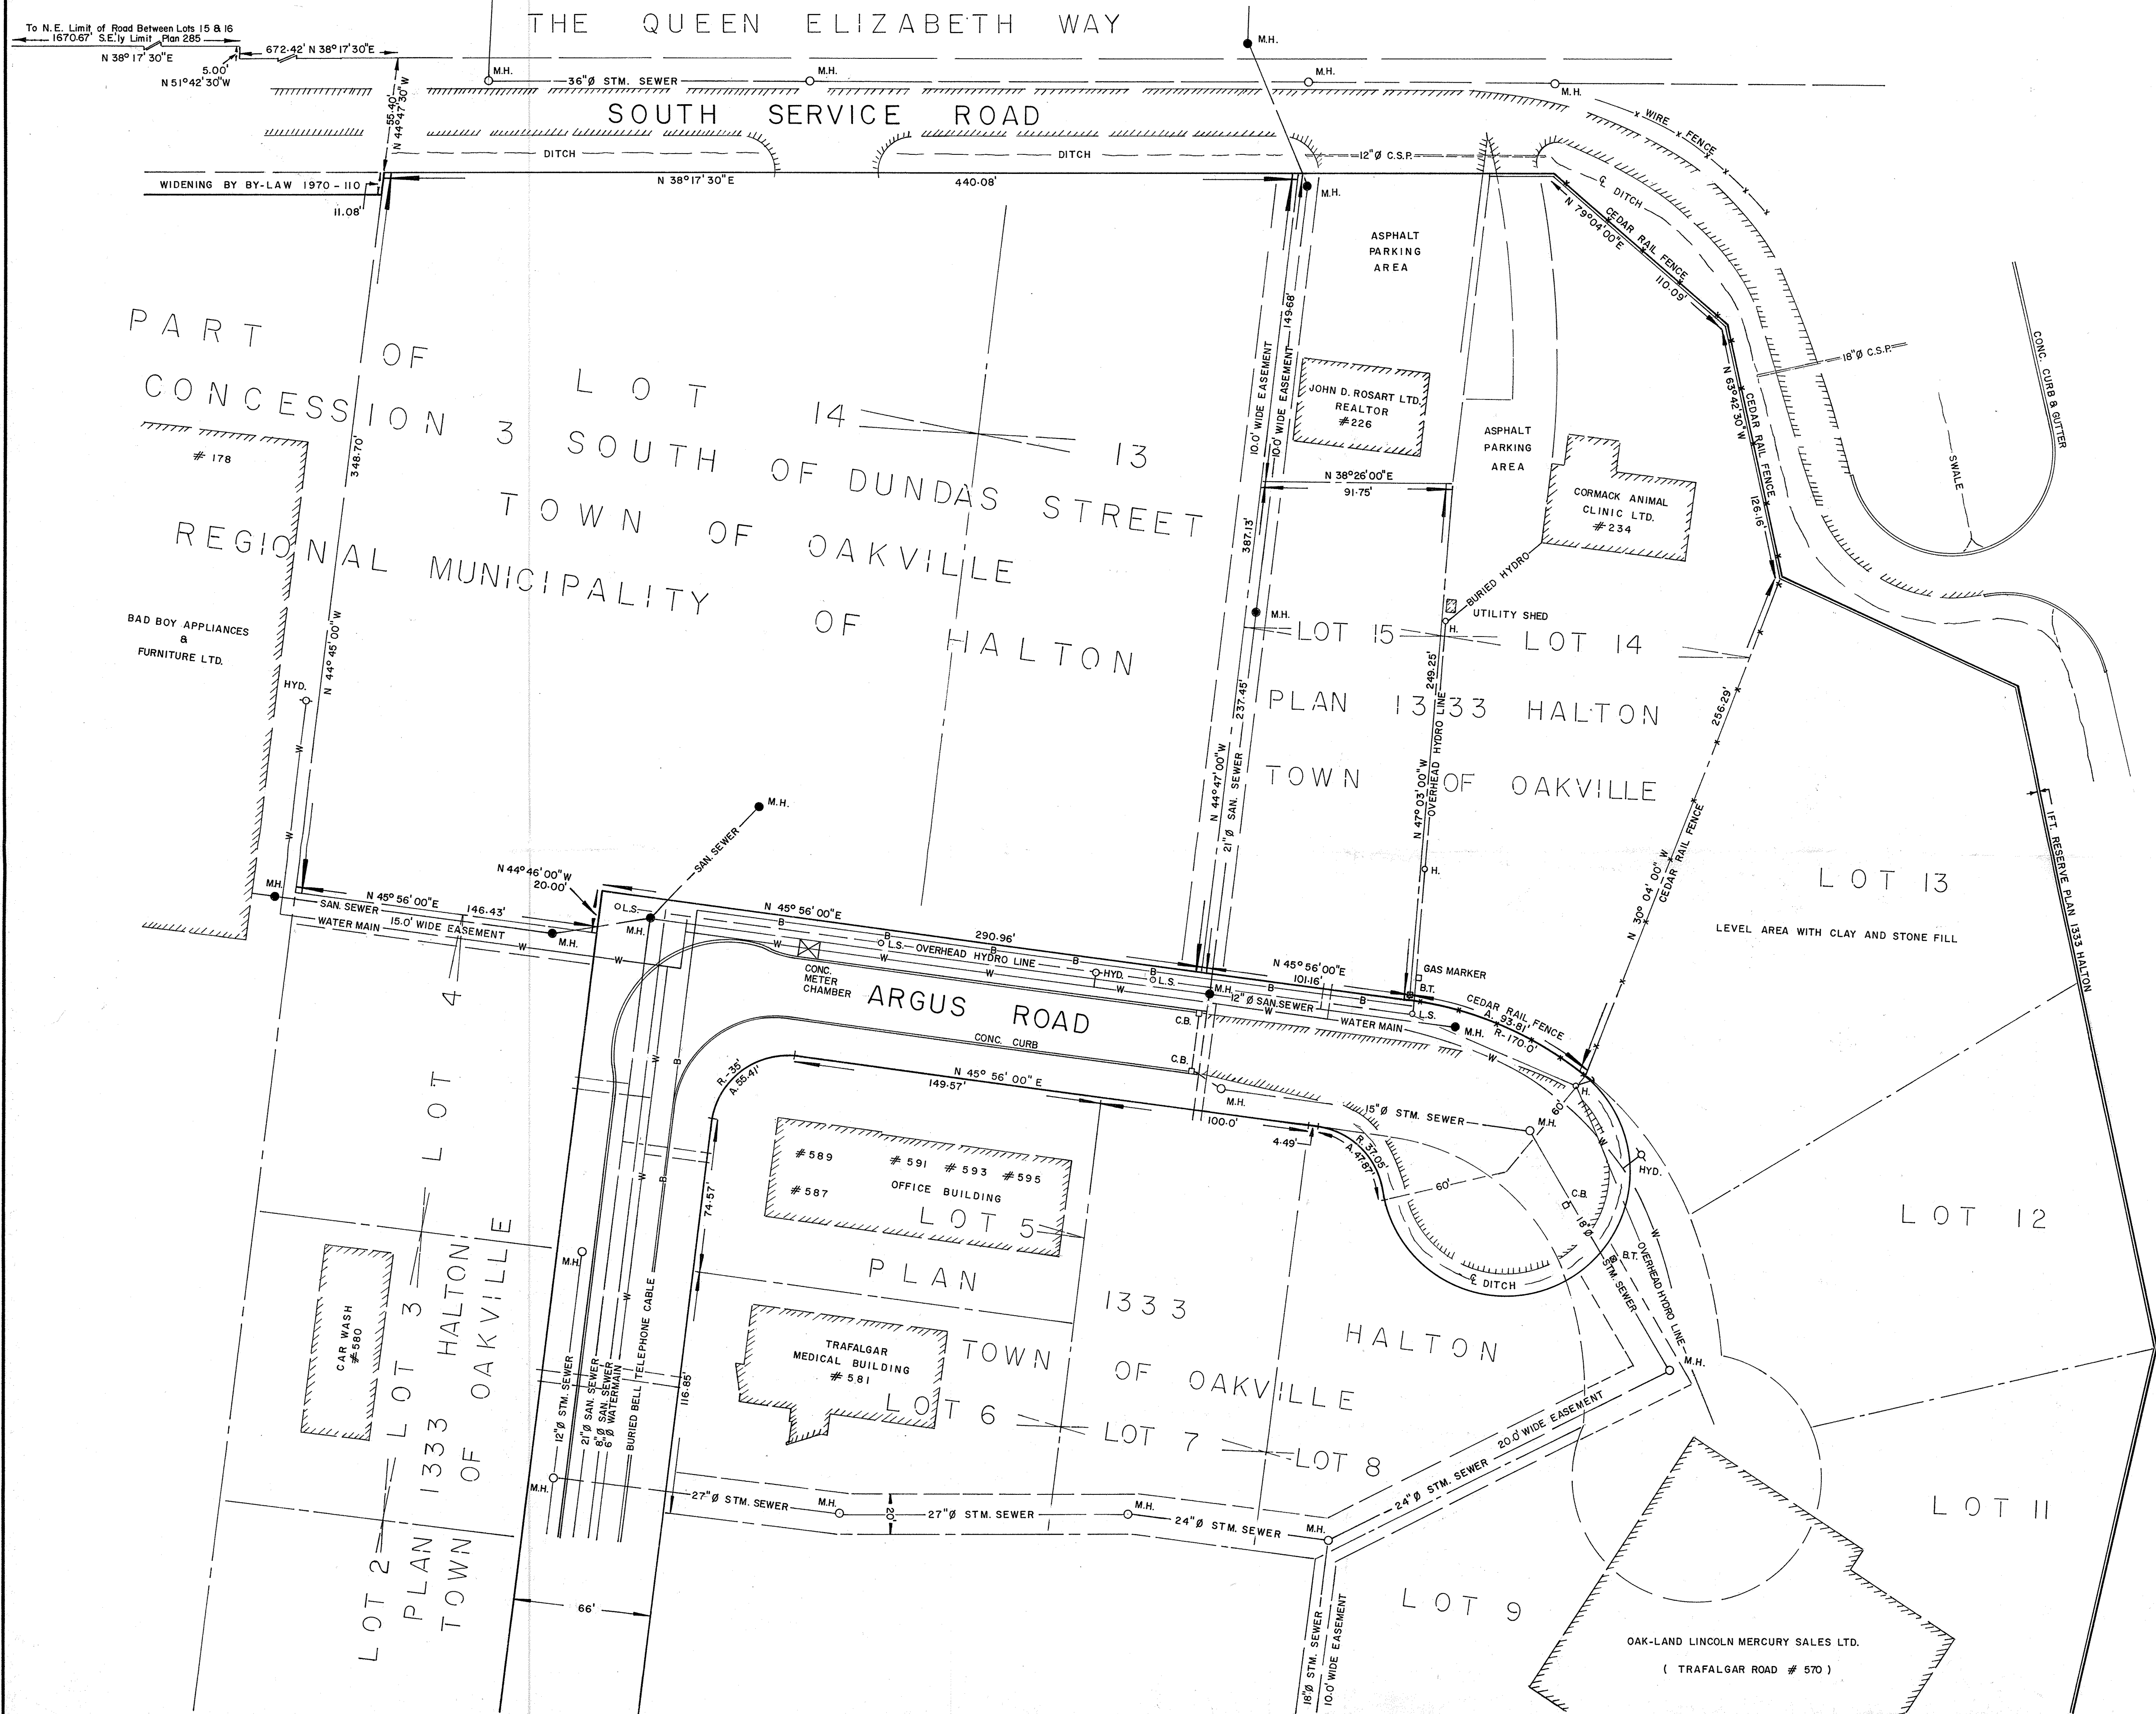

GENERAL NOTES

— ALL DRIVEWAYS GRAVEL UNLESS OTHERWISE NOTED.

— ALL SERVICE LOCATIONS ARE APPROXIMATE AND MUST BE LOCATED ACCURATELY IN THE FIELD.

LEGEND

STM. M.H.

SAN. M.H.

W-W

G-G

B-B

H.P.

HYD.

STORM SEWER & MANHOLE

SANITARY SEWER & MANHOLE

WATERMAIN & VALVE

GASMAIN & VALVE

BELL TELEPHONE BURIED CABLE

HYDRO POLE & GUY ANCHOR

HYDRANT

TOWN OF OAKVILLE
ENGINEERING DEPARTMENT

FLD. BK. No.

DATE: MAY 1977

DRAWN BY: D.A.

CHK'D. BY:

FILE No:

HOR: 1" = 40'

DESIGN BY:

SURVEY BY: J.A./M.D.


INSPECTOR:


CONTRACTOR:

PLAN
No. C-626A

SHEET OF


DATE REVISIONS BY

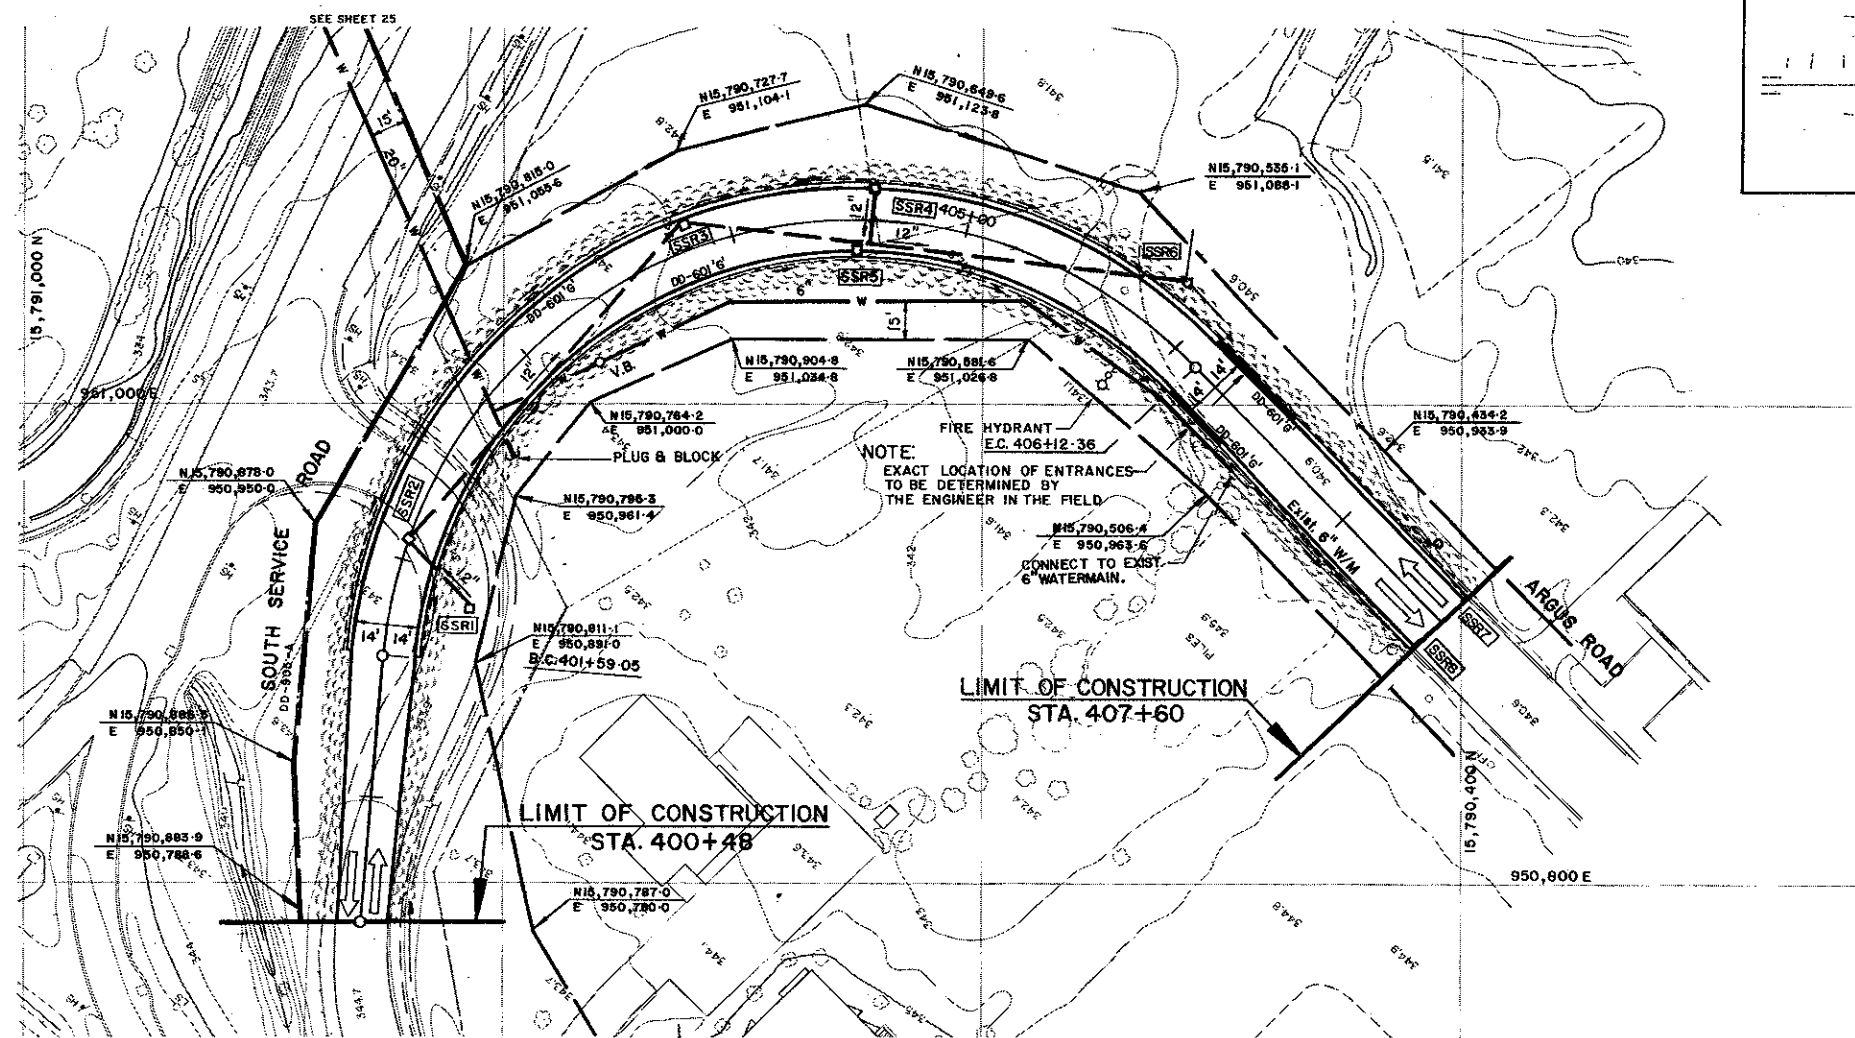

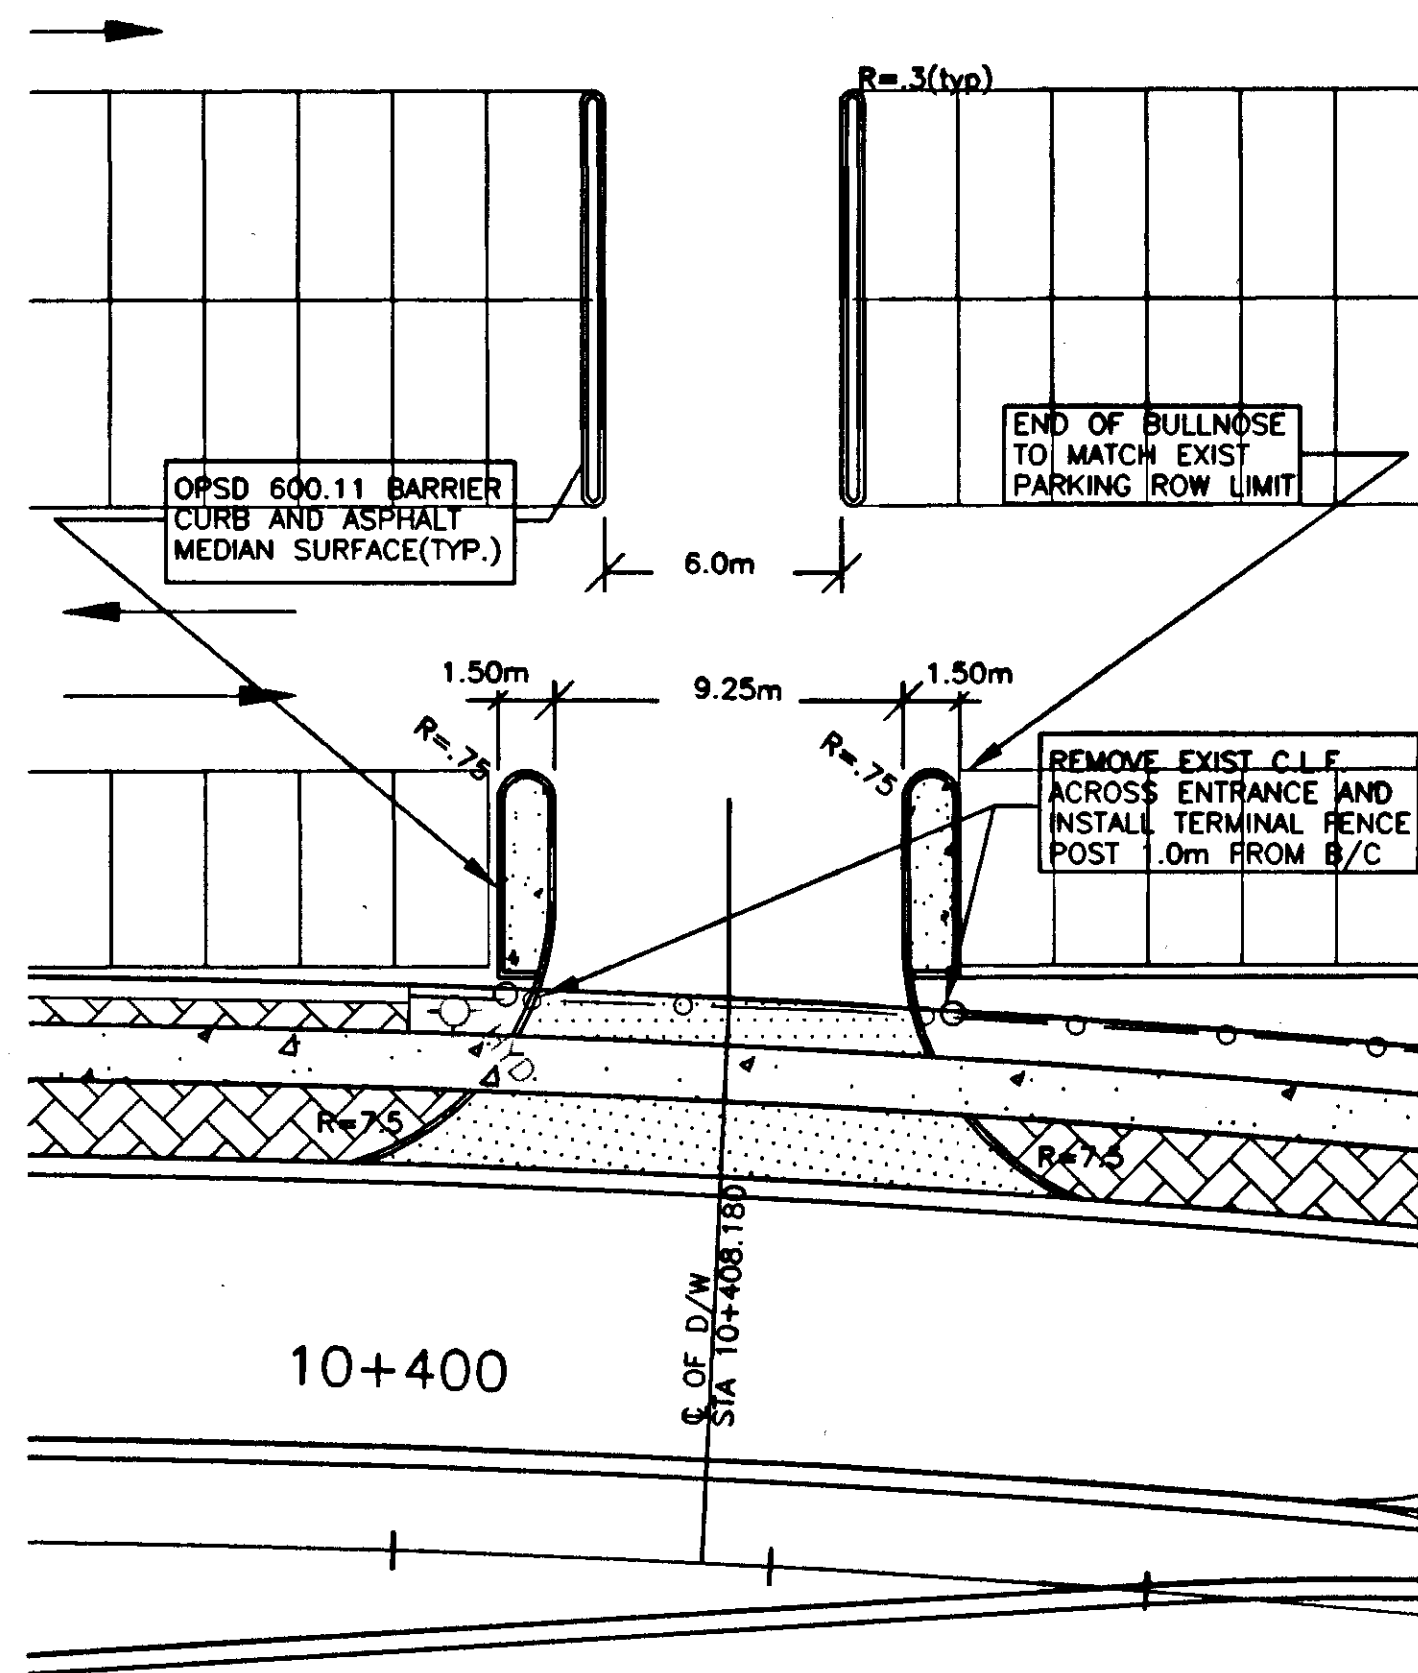


DETAIL OF RELOCATED GO ENTRANCE

SCALE 1:200

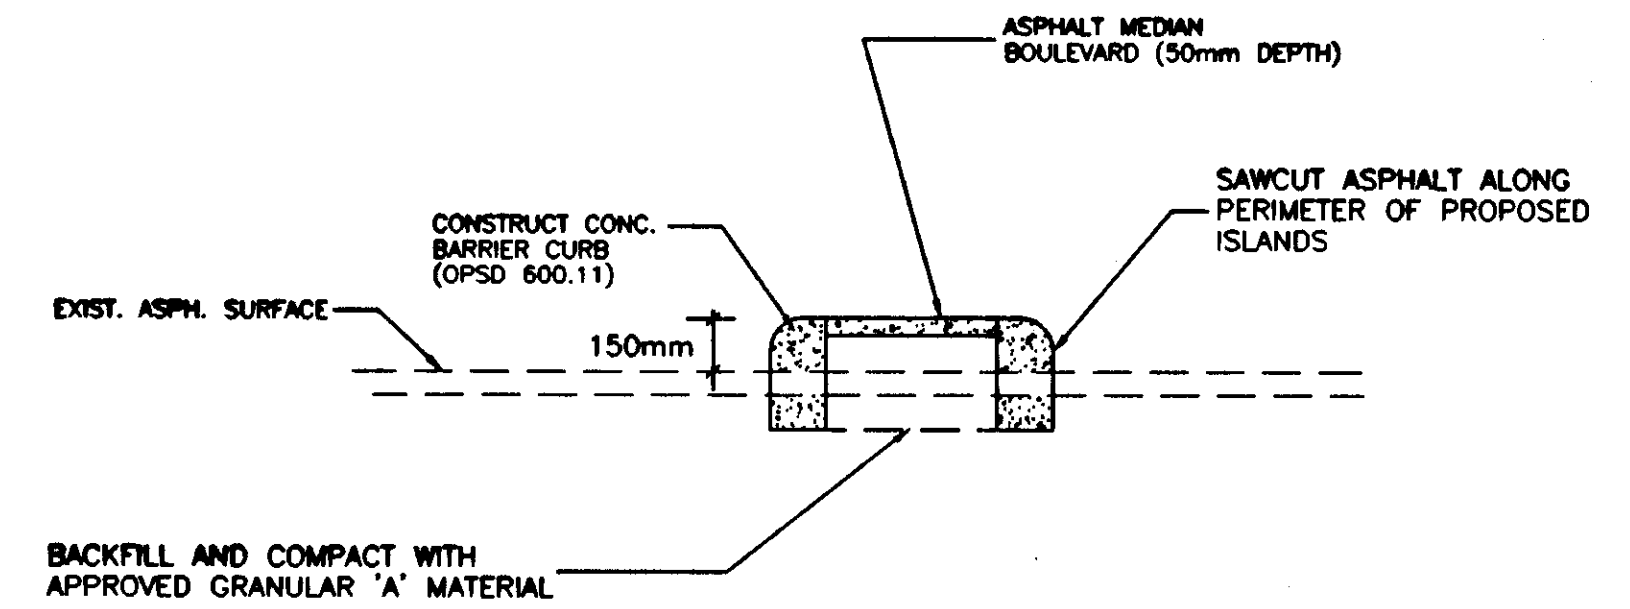

TYPICAL X-SECTION FOR GO PARKING LOT MEDIANS

N.T.S.

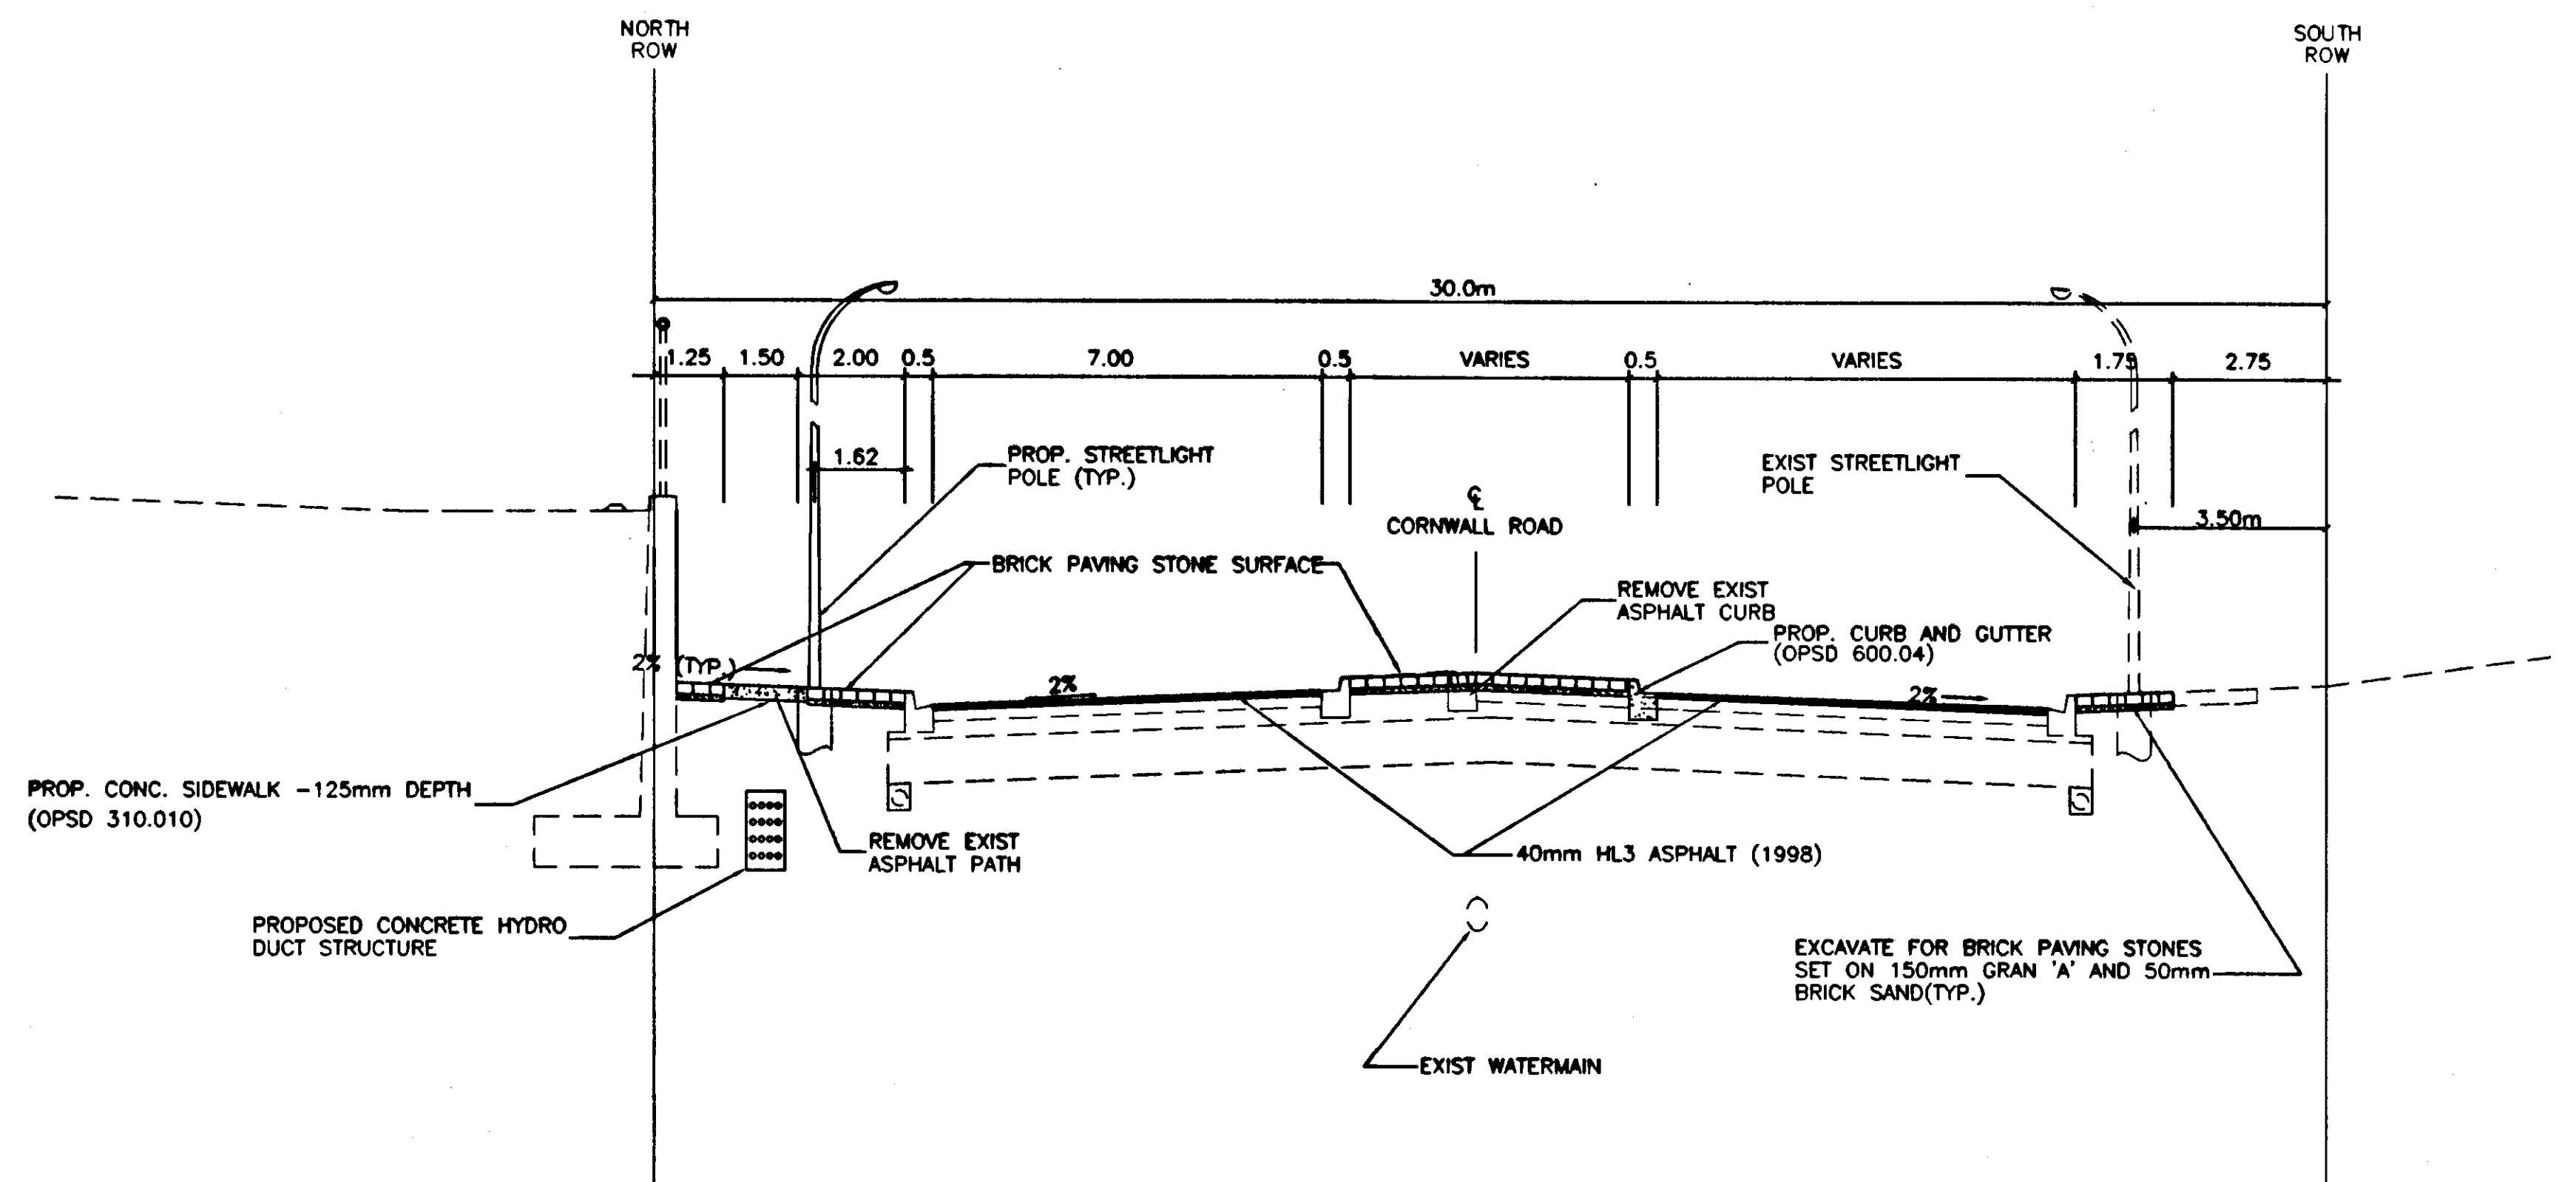


TYPICAL CROSS SECTION 10+365 (CORNWALL ROAD)

HOR. 1 : 100

VER. 1 : 50


Approvals Municipal: <i>[Signature]</i> R. Green, P.Eng., Acting Director of Public Works				Design: EZ Drawn: EZ Scale: Date: L.D. McLEOD REGISTERED PROFESSIONAL ENGINEER PROVINCE OF ONTARIO		Field Notes Bell ☐ Hydro ☐ Gas ☐ Cable ☐ Traf. ☐ Water ☐		CONSULTANT MUNICIPALITY Town of Oakville Department of Public Works		TITLE Cornwall Road Construction Stage 2 Typical Cross Section and Details	
1 970806 EZ ISSUED FOR CONSTRUCTION No. Date By Revisions		No. Date By Revisions		No. Date By Revisions		No. Date By Revisions		MUNICIPAL DRAWING NO. R-318-97-04		REGIONAL DRAWING NO.	
								CONTRACT NO. R-318-97		SHEET 4 of 17	

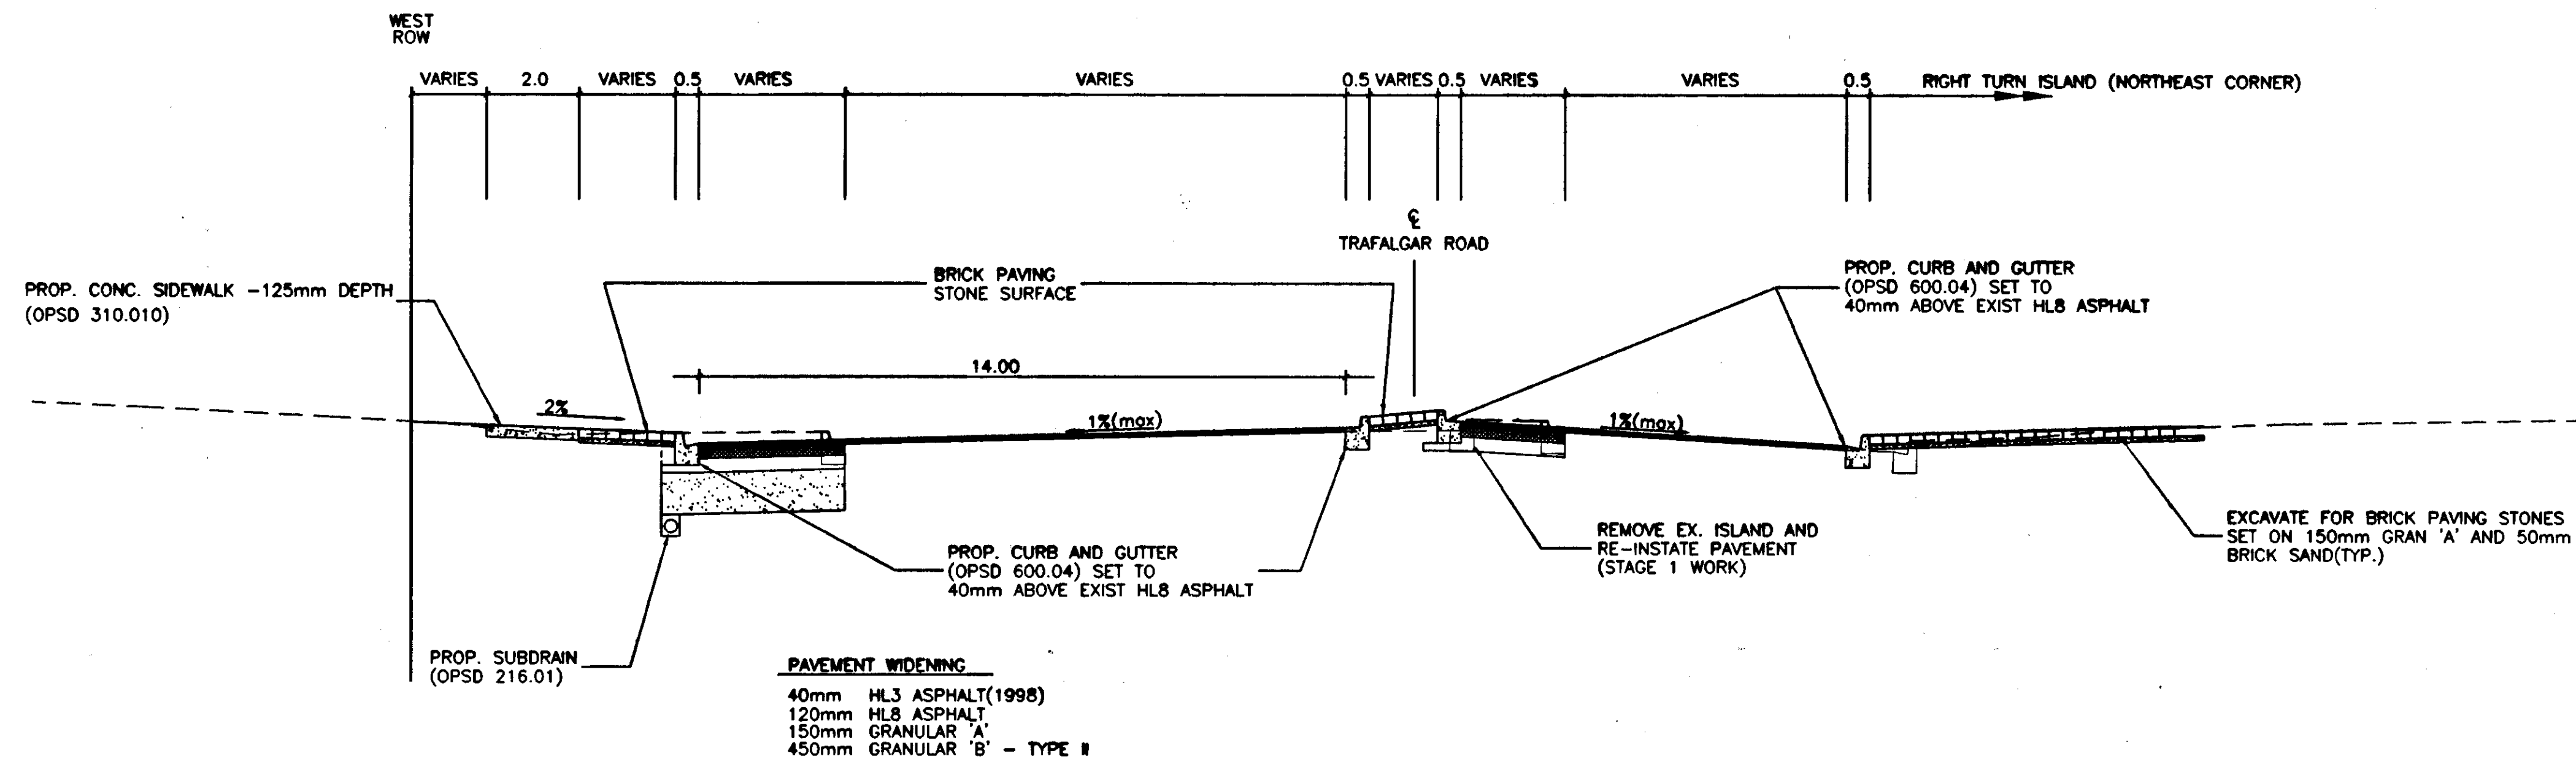

TYPICAL CROSS SECTION 0+390 (TRAFALGAR ROAD)

HOR. 1 : 100

VER. 1 : 50

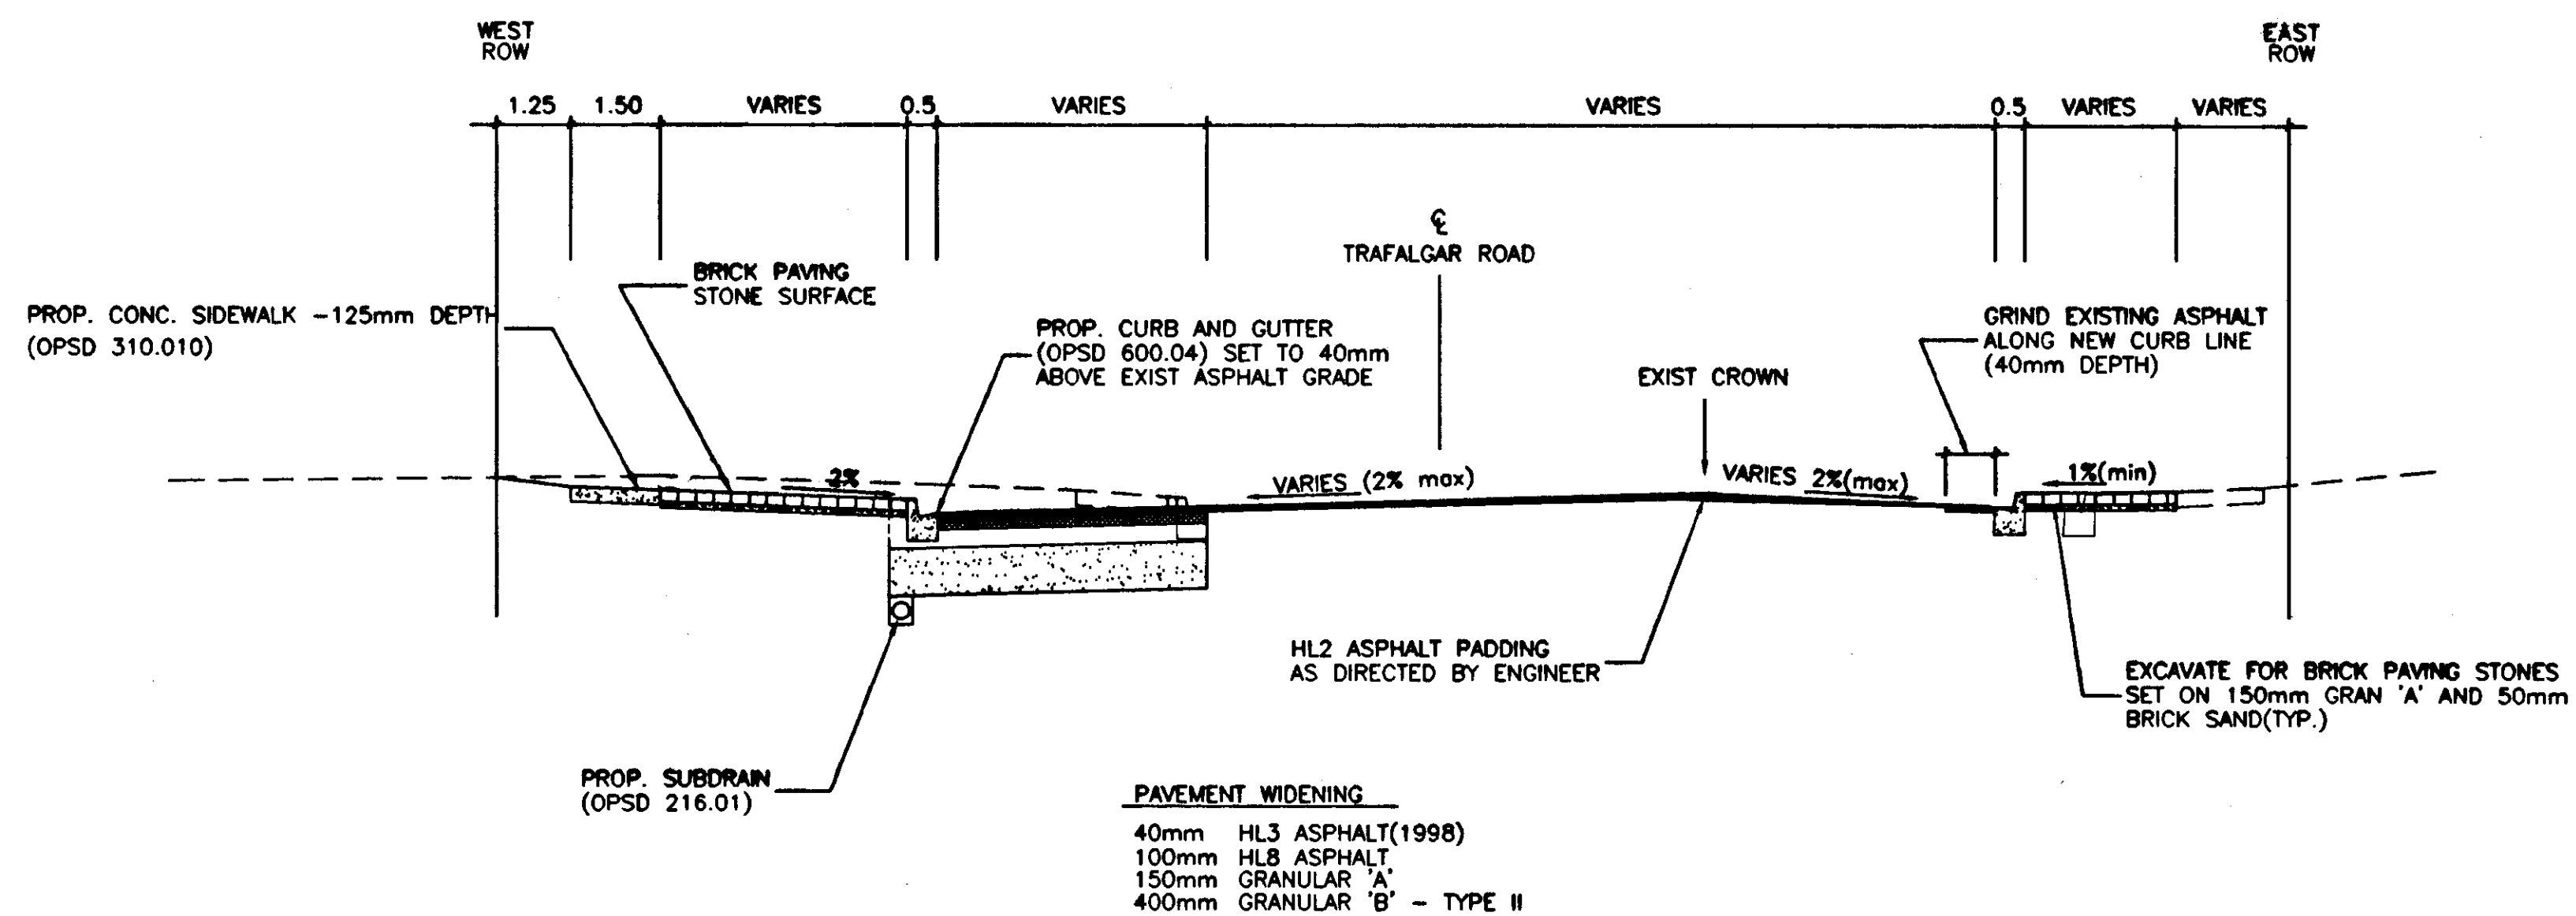

TYPICAL CROSS SECTION 0+300 (TRAFALGAR ROAD)

HOR. 1 : 100

VER. 1 : 50

Approvals Municipal R. Green, P.Eng., Director of Public Works				Stamp L. D. McLEOD REGISTERED PROFESSIONAL ENGINEER PROVINCE OF ONTARIO		Design EZ Chk'd LDM Scale Date				Field Notes Bell ☐ Hydro ☐ Gas ☐ Cable ☐ Traf. ☐ Water ☐				CONSULTANT TITLE Cornwall Road Construction Stage 2 Typical Cross Sections MUNICIPALITY Town of Oakville Department of Public Works			
Revisions No. Date By				Revisions No. Date By				MUNICIPAL DRAWING NO. R-318-97-06 CONTRACT NO. R-318-97				REGIONAL DRAWING NO. SHEET 6 OF 17					

